



A. SOUTH ELEVATION 1/4"=1'-0"

NOTE - CENTER DOORMER ALTERNATE G-4 NOT BUILT


NOTE - DOUBLE GABLE NOT INSTALLED ON CHOWAN COUNTY SITE

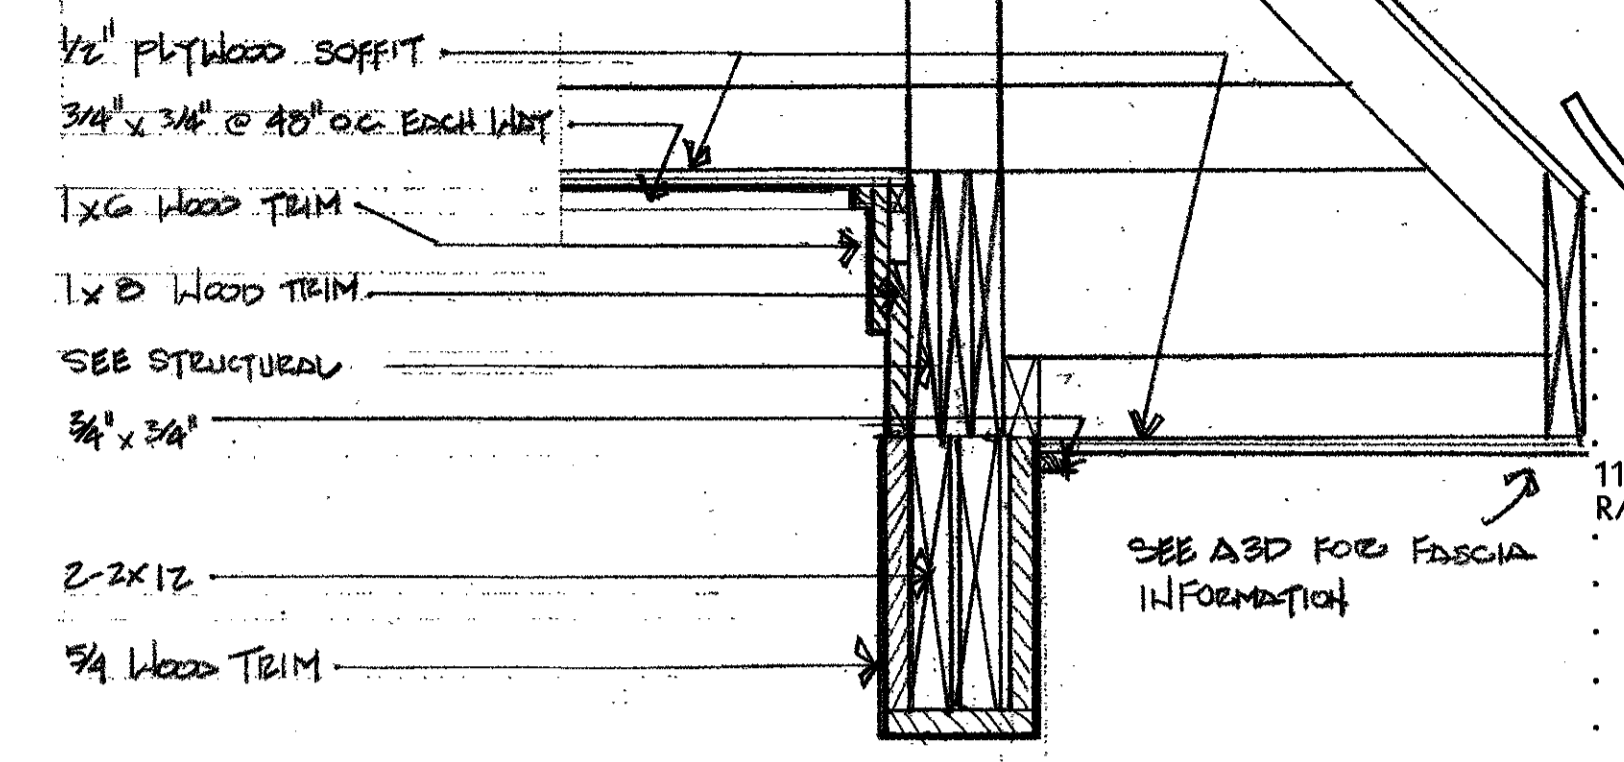


E. SECTION SCALE 1 1/2"=1'-0"

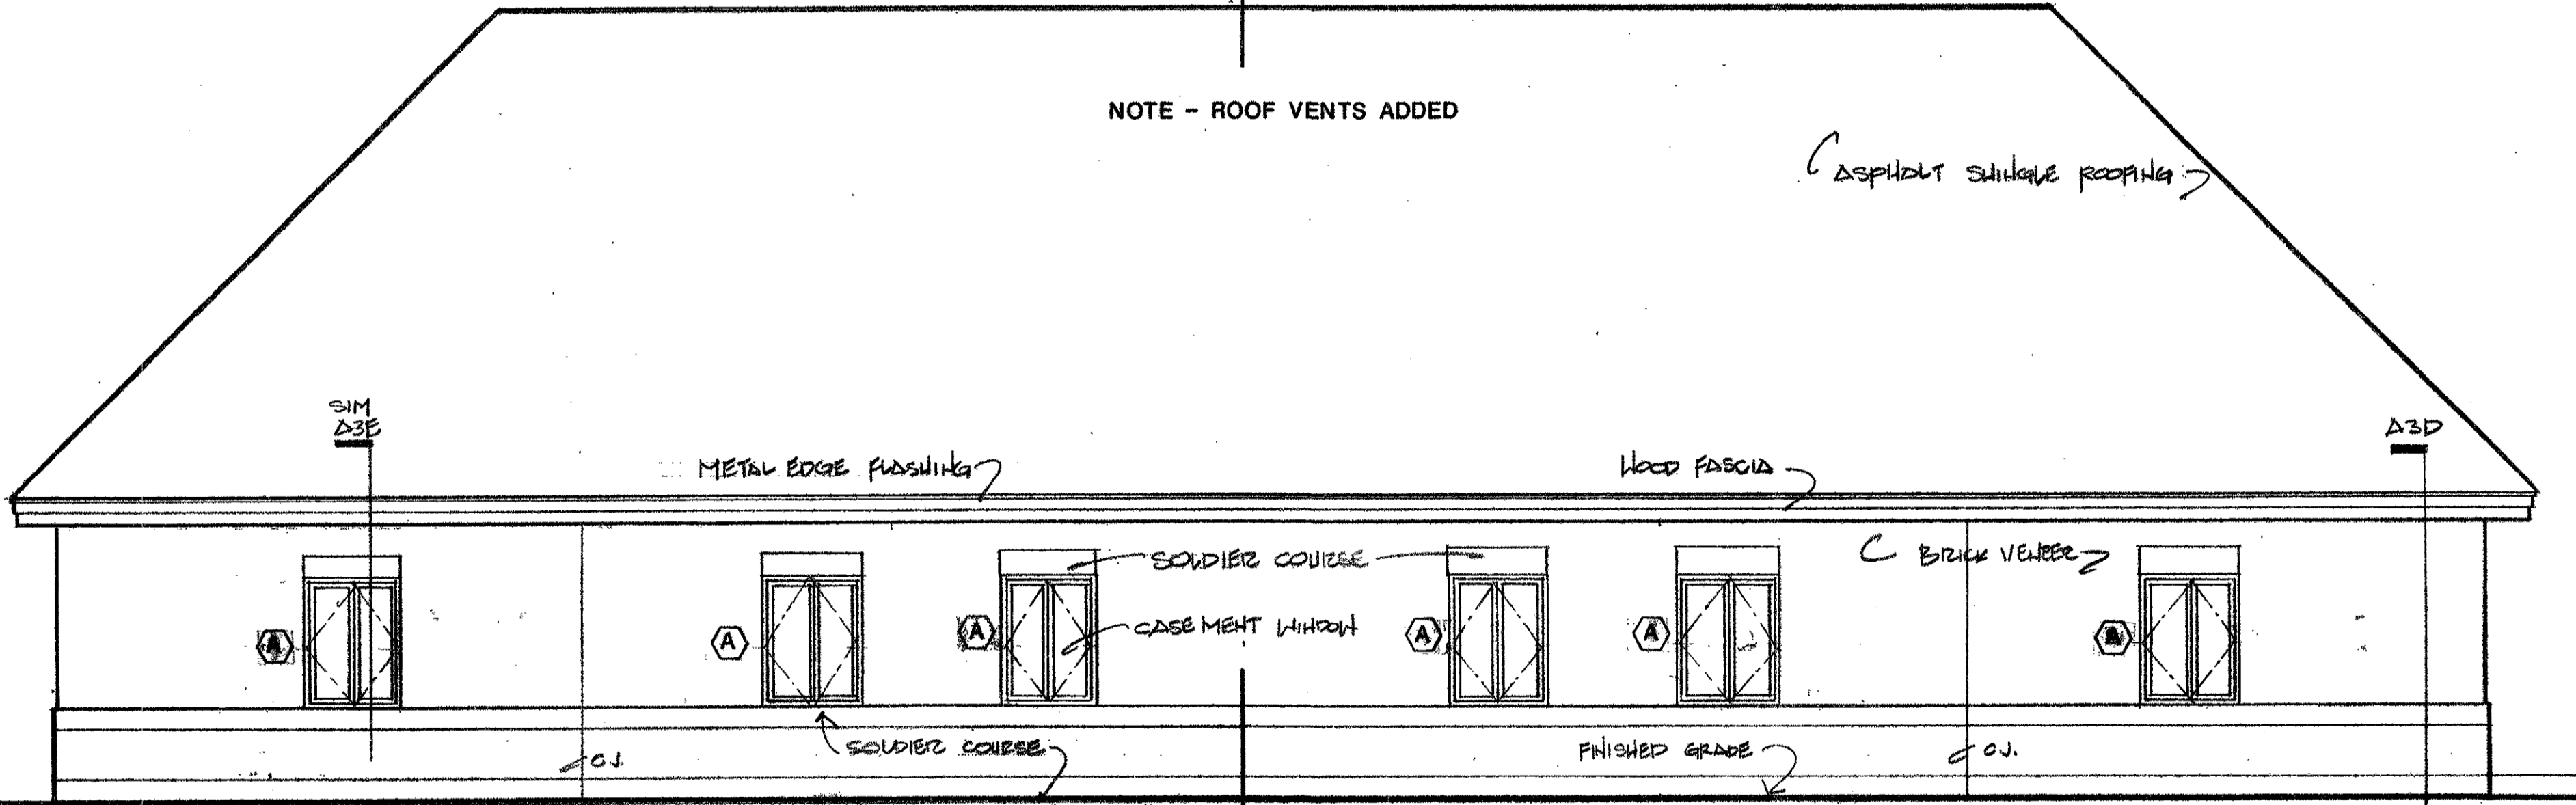


B. NORTH ELEVATION 1/4"=1'-0"

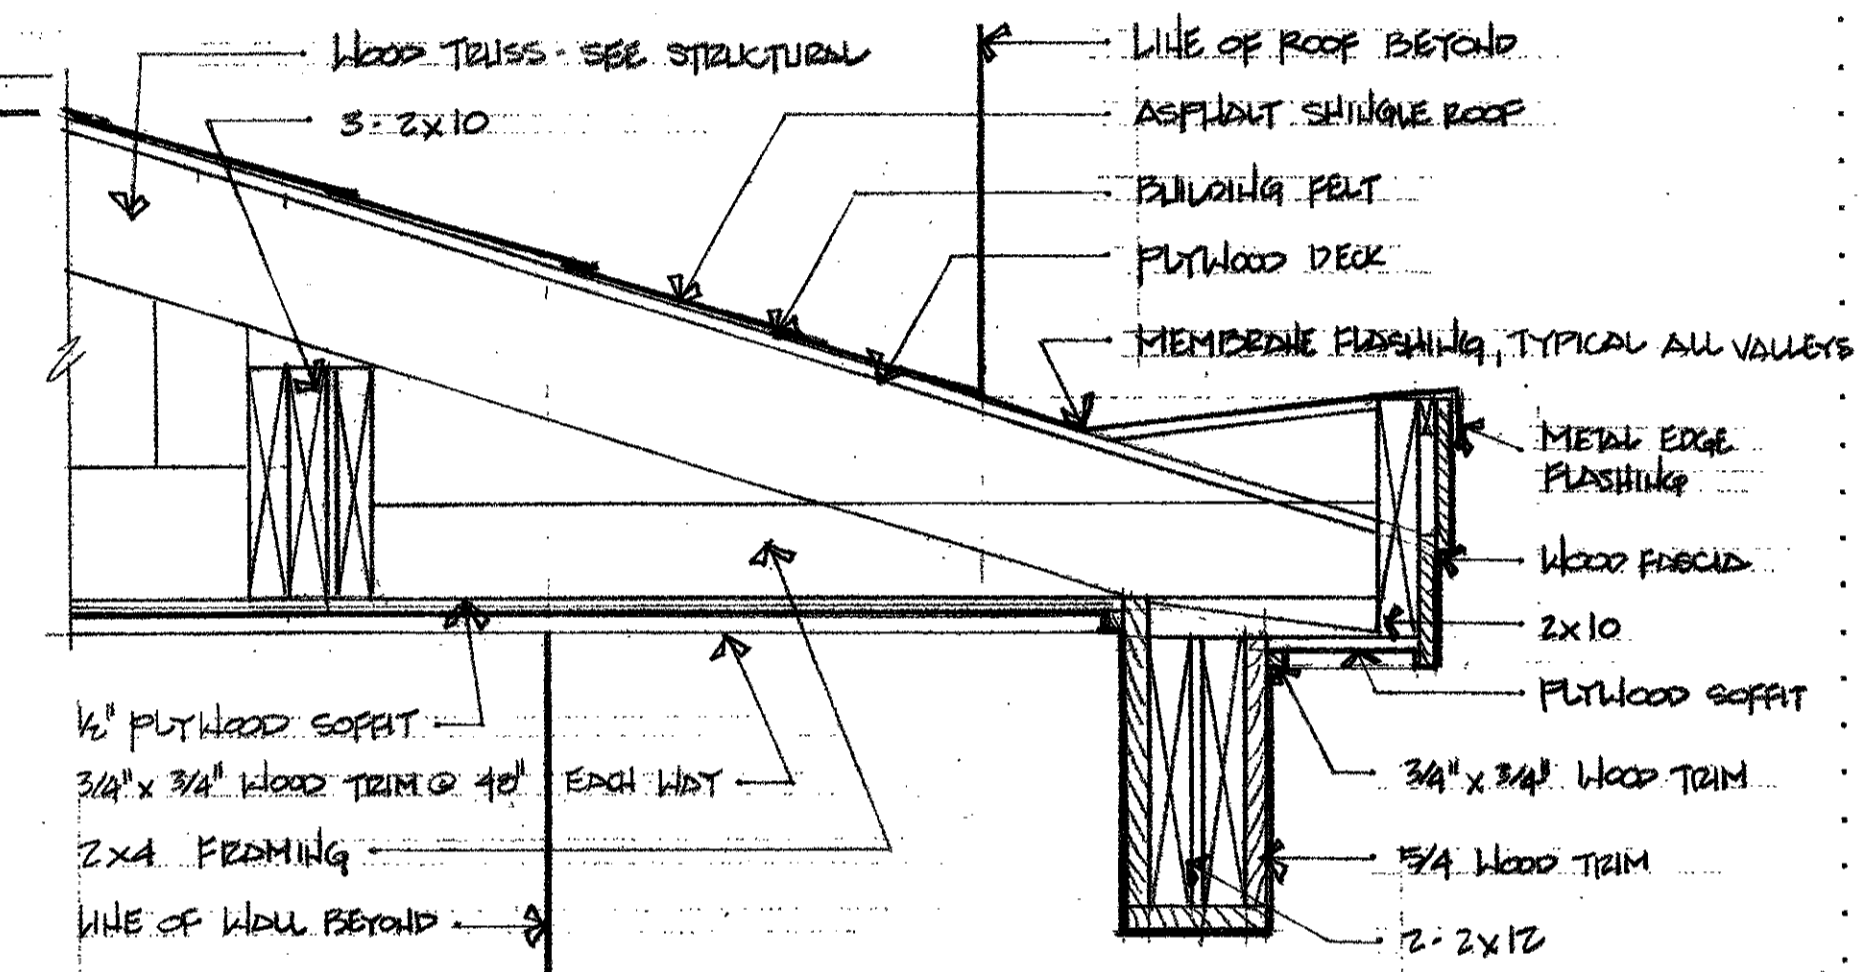

F. SECTION SCALE 1 1/2"=1'-0"

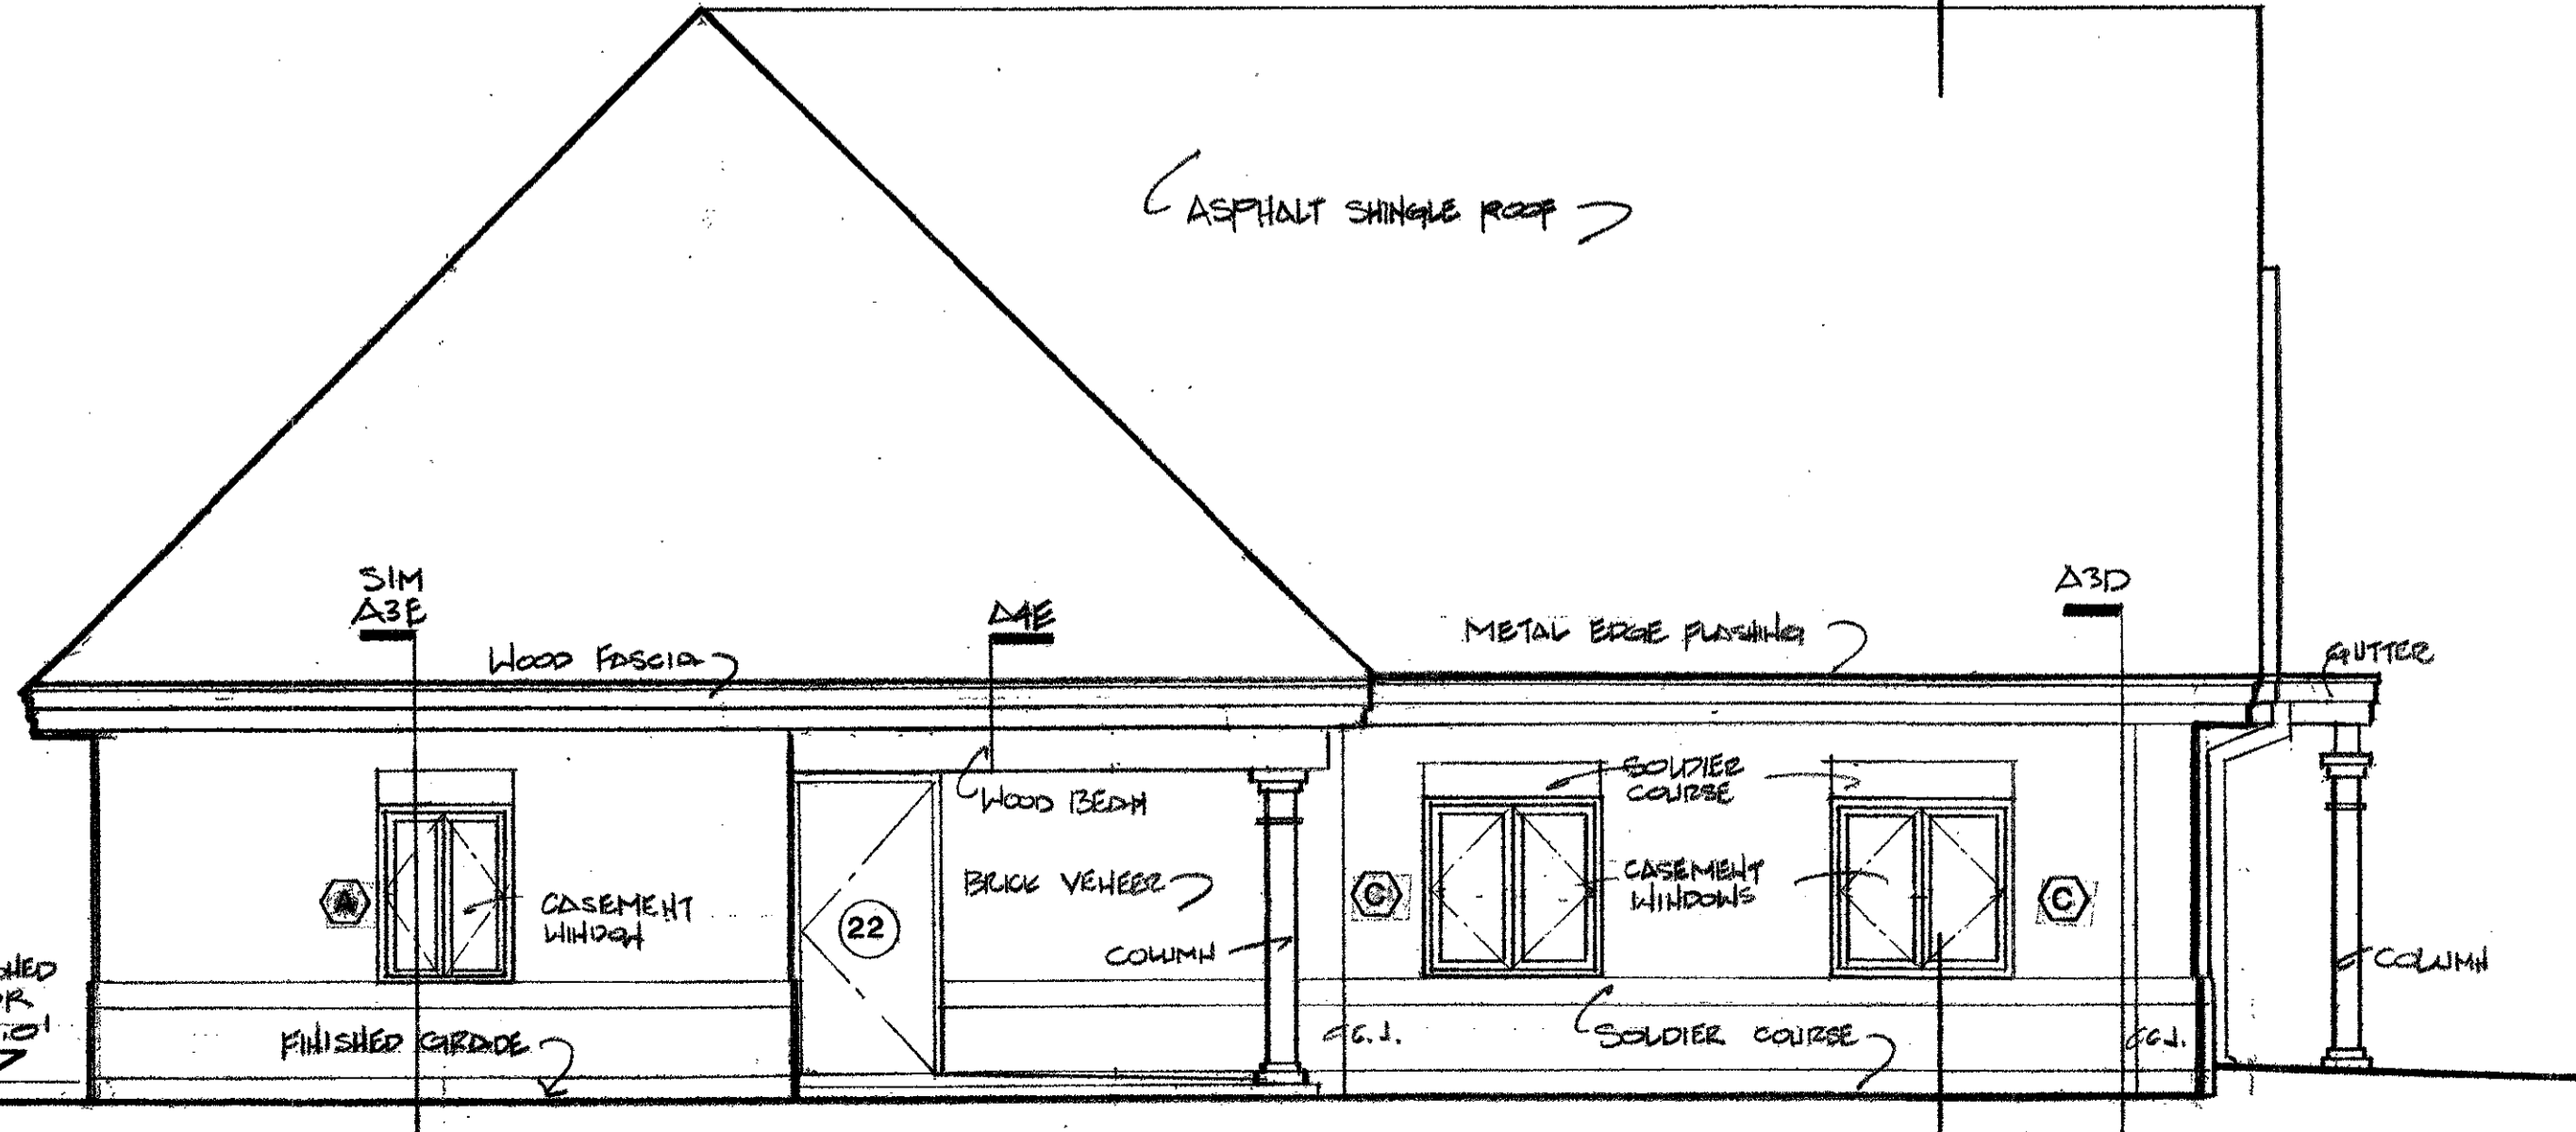


C. WEST ELEVATION 1/4"=1'-0"

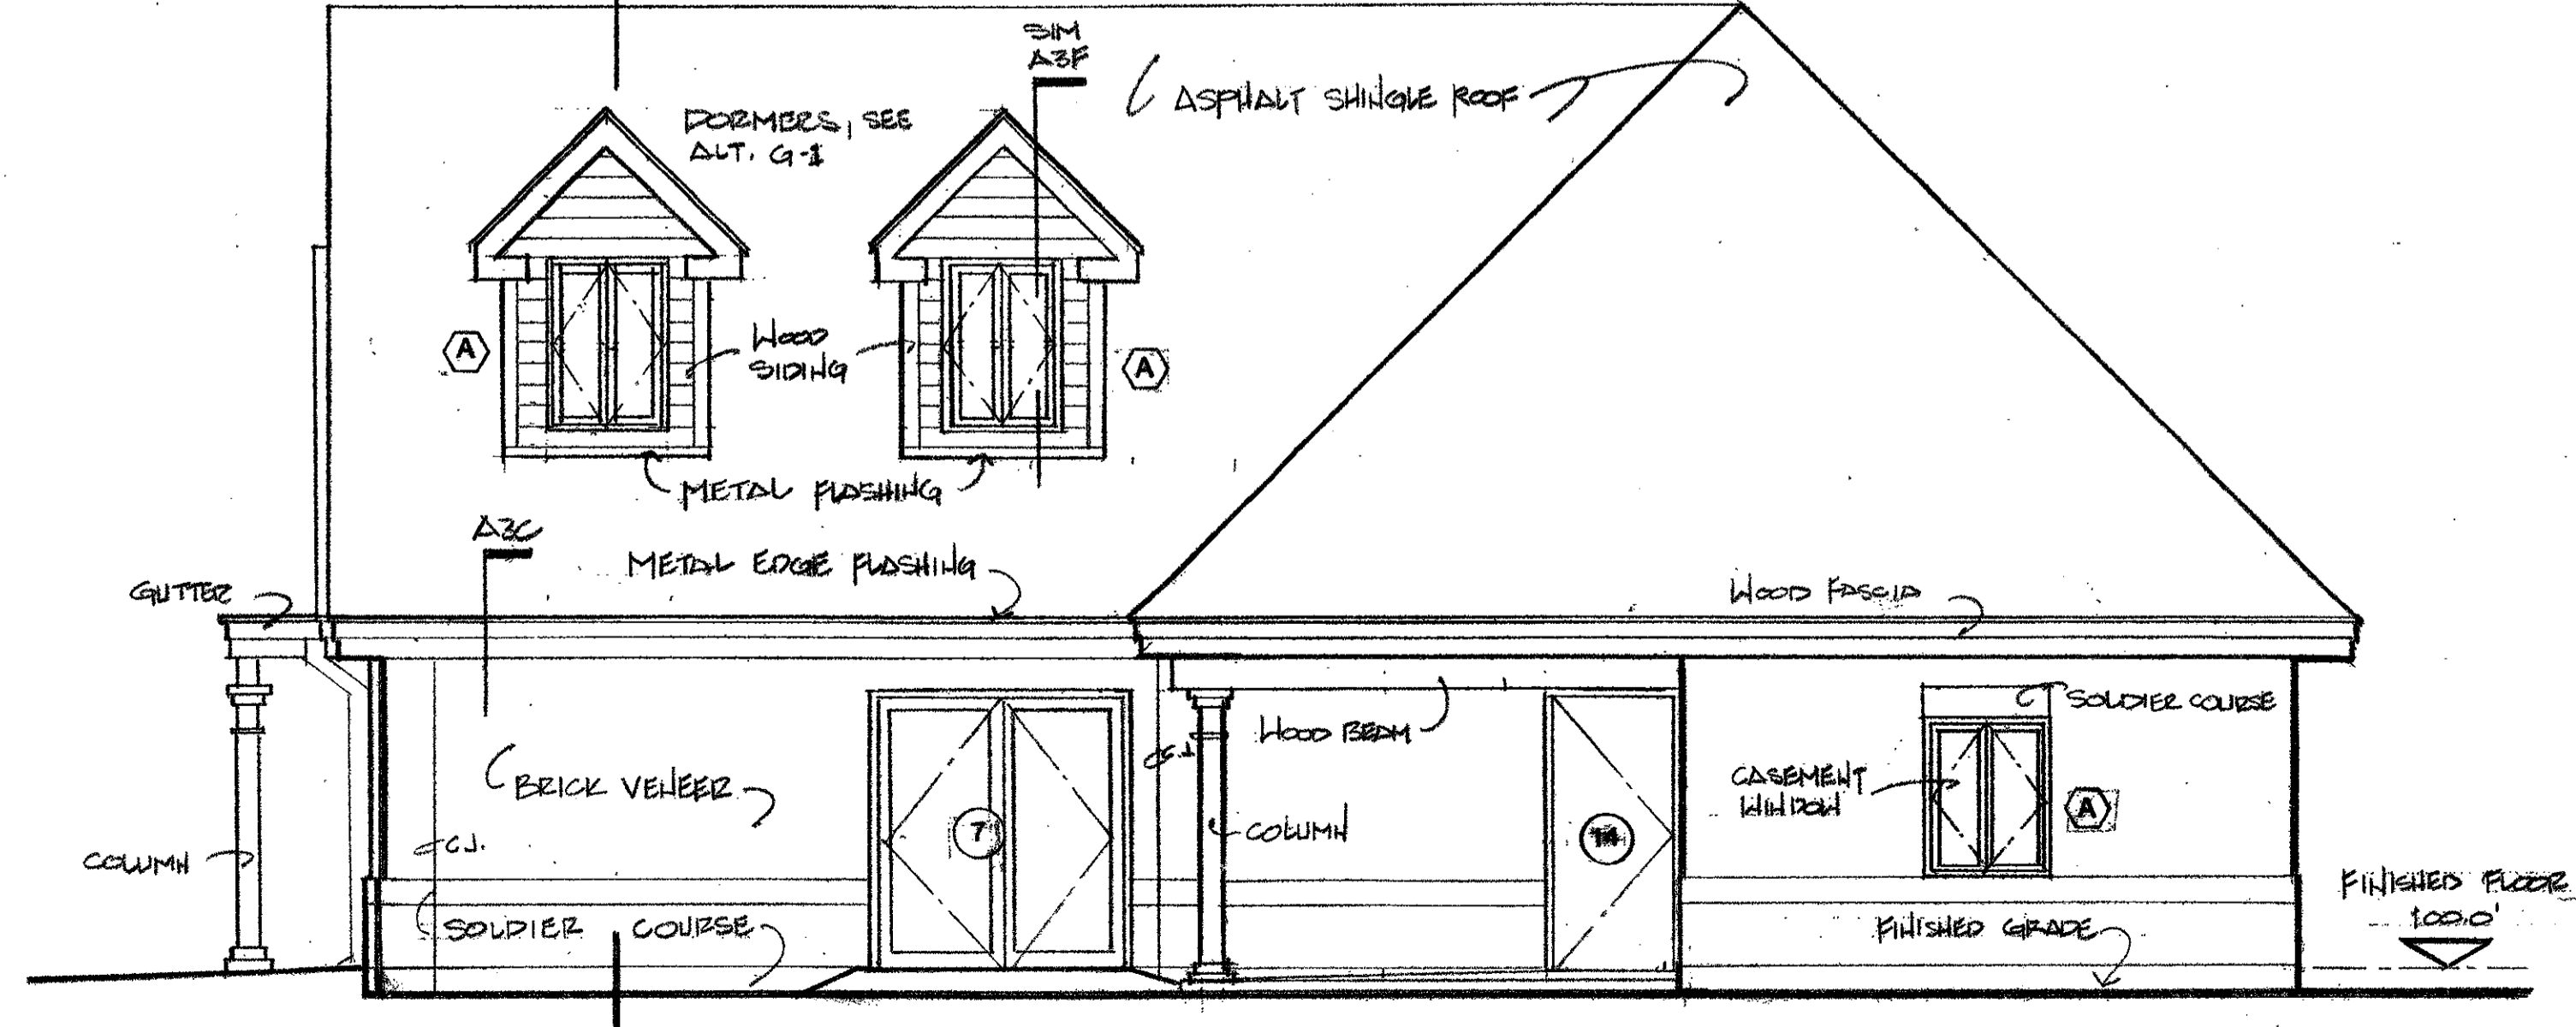

D. EAST ELEVATION 1/4"=1'-0"

Record Drawings
1 October 1993

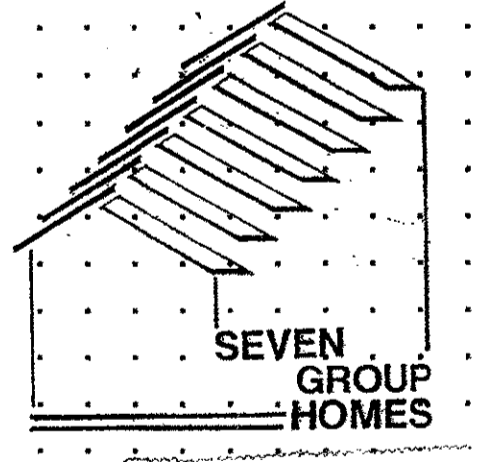

BUILDING ELEVATIONS & DETAIL

Date: 6 JULY 1992
Checked: SDS
Drawn: SDS/SDD